


Section 1:20


Plan 1:20

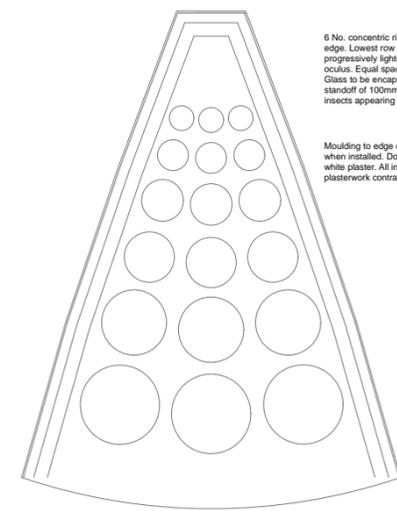



Flattened Plan (Approximate) of Upper Dome Segment 1:10

6 No. concentric rings of circular openings with detail to edge. Lowest row of openings in mid-blue glass, with progressively lighter shades of blue glass closer to oculus. Equal spacing between openings (40mm). Glass to be encapsulated by polycarbonate with a standoff of 100mm to prevent the shadows of dead insects appearing on the glass.

Moulding to edge of panel (see detail) to form a rib when installed. Dome to give the appearance of matt white plaster. All internal support to be by the plasterwork contractor.

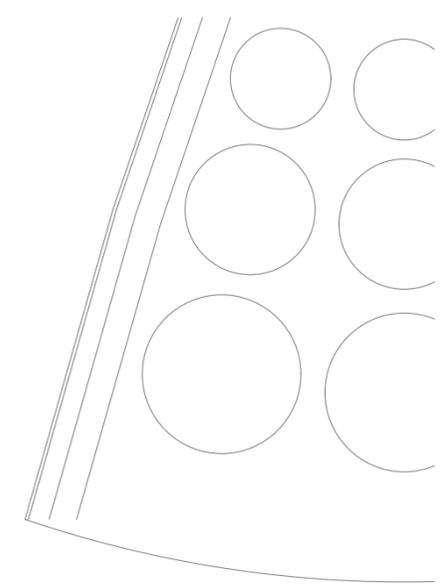

Detail Section of Upper Dome 1:5

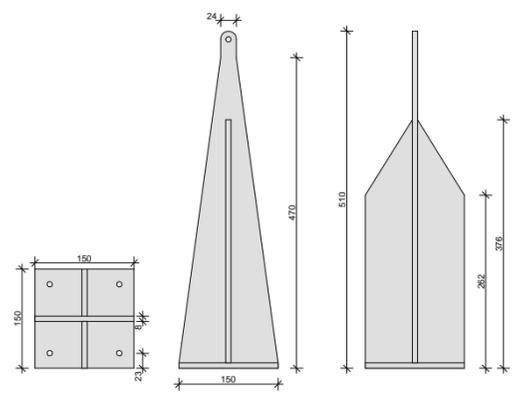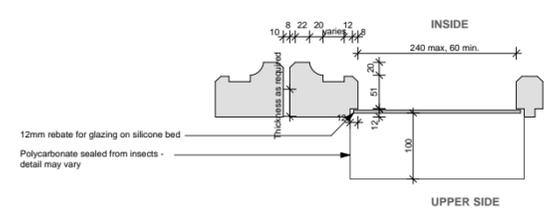

Detail of Chandelier Suspension Bracket 1:5

Job title
**Adshedd Park
 Lower Basildon
 Berkshire RG8 9TA**

Drawing title
Internal Dome

Scale 1:20, 1:10, 1:5	Date 05/07	Drawn C.K.
--------------------------	---------------	---------------

AS BUILT
 50% FULL SIZE

hives architects
 43 South Street, Reading RG1 4QU
 telephone 0118 958 7331
 fax 0118 939 4119
 email admin@hivesarchitects.co.uk

2308 387 P1